


Te Awamutu Plumbing &
Drainage

AS LAID DRAINAGE PLAN

STREET: WHISTLER CLOSE	No: 11	LOT: 182	DPS
OWNER:	DRAINLAYER: NATHAN GREEN		
INSPECTOR:	REG No: 21933		
DATE OF INSPECTION: 26.10.07	CONSENT No: 2007/19033		
DRAINLAYER PLEASE FILL IN ALL DETAILS			

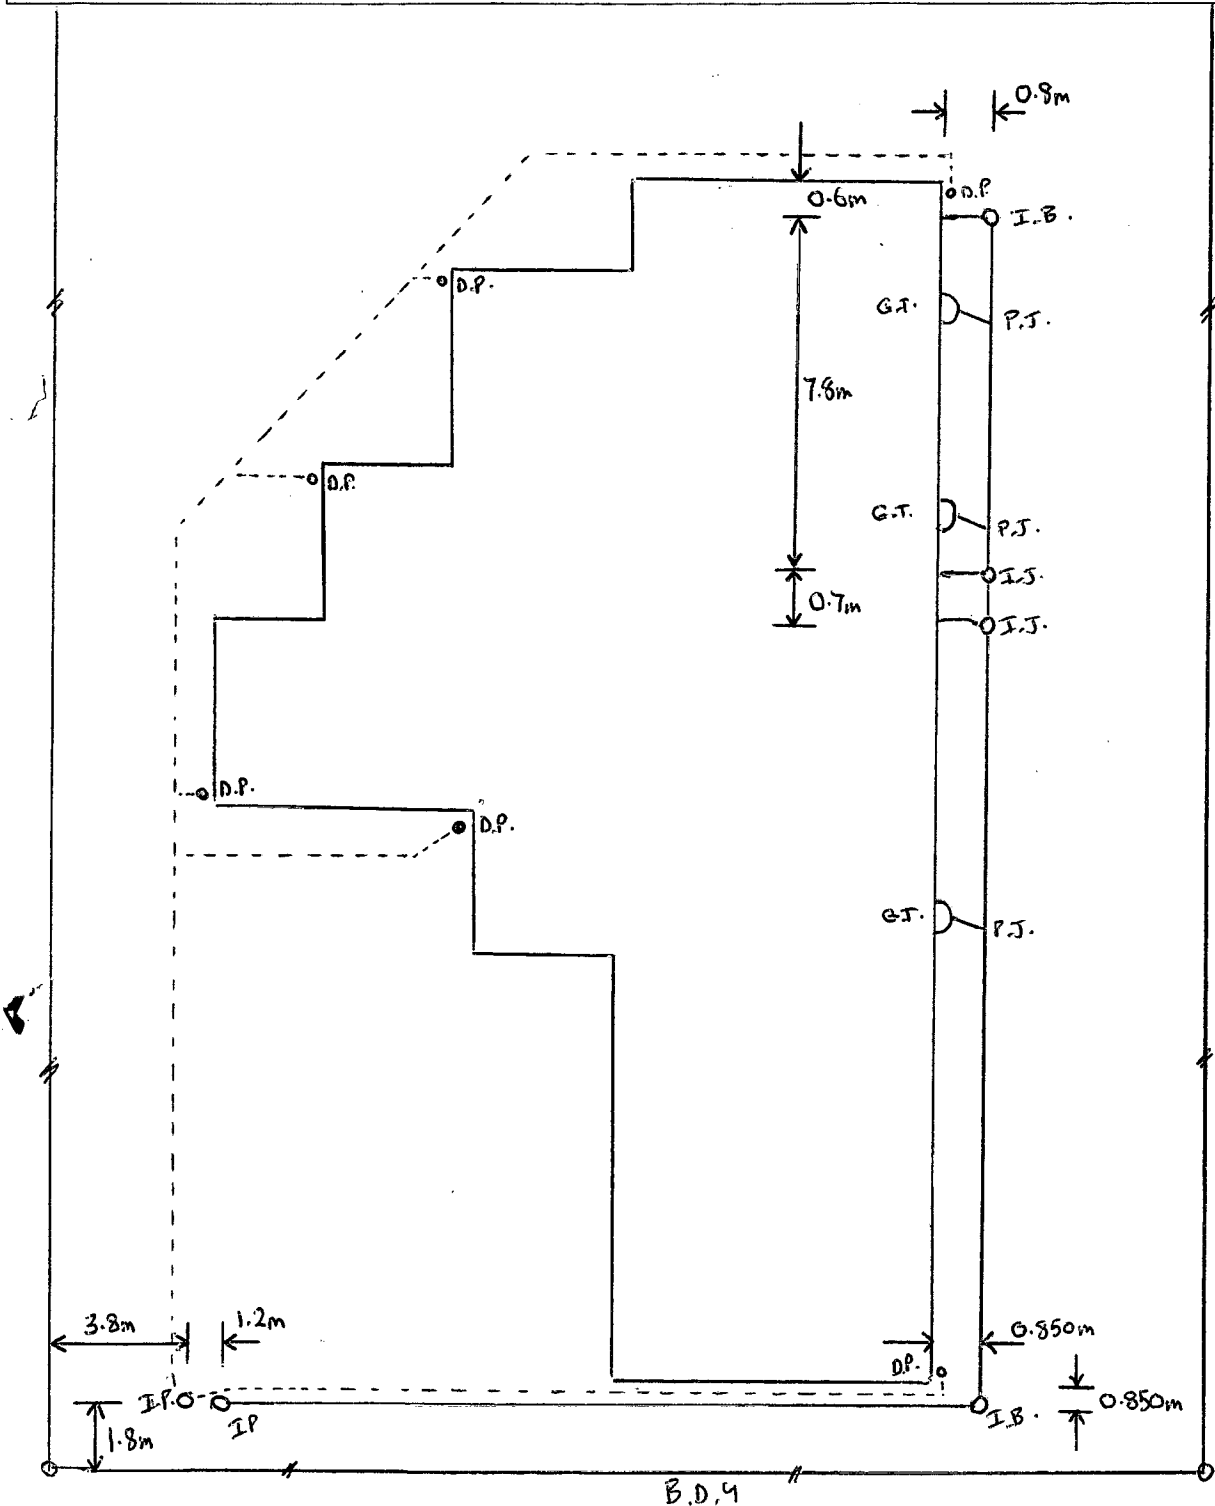

DRAINLAYER'S SIGNATURE: _____

DATE: 25.10.07