



BUILDING UNIT

AS LAID DRAINAGE PLAN

STREET: Land Mark Crt **No:** 19

LOT: _____ **DPS** _____

OWNER: M BJT Developments

DRAINLAYER: John Viggers


INSPECTOR: Craig

REG No: 106828

DATE OF INSPECTION: _____

CONSENT No: 2013/28690

DRAINLAYER PLEASE FILL IN ALL DETAILS

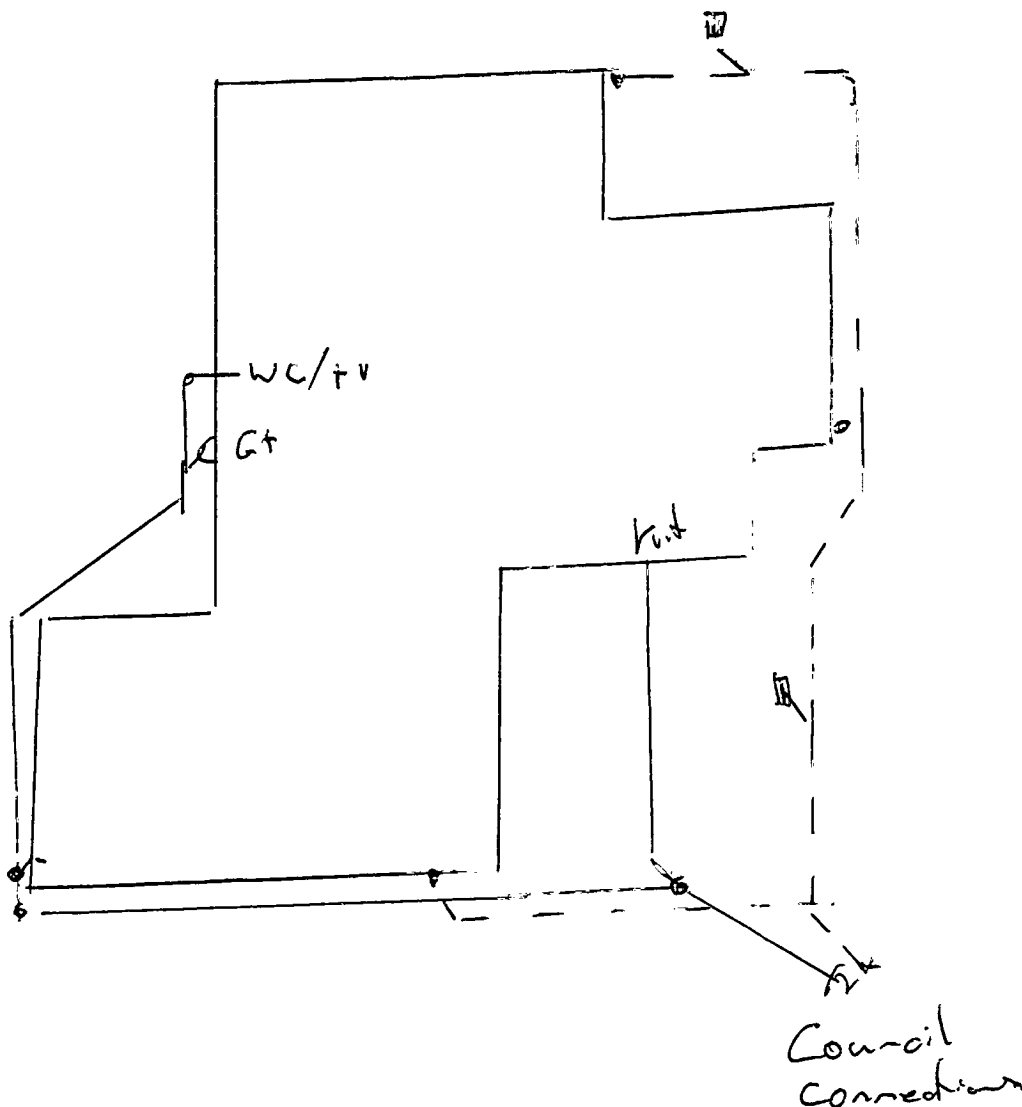

DRAINLAYER'S SIGNATURE: _____

DATE: 18-11-13