As Laid

OFFICE OF THE CHIEF BUILDING SUPERVISOR
PRIVATE BAG, HAMILTON, N.Z.
PHONE 386-699

HAMILTON CITY

APPLICATION FOR PERMIT FOR SANITARY, PLUMBING AND DRAINGAGE WORK

I, the undersigned (name in full) P. Graham address .....

Hereby make application for permission to carry out the work prescribed herein, as set out in the plans attached hereto, at the premises situated in:-

55 Delamere St Street/Road, being Lot 106 D.P.S. 38845

Name and Address of owner of premises: A.D. & M.J. McQueen.

Nature of Work S/S S/D to new dwelling

Value of proposed work excluding materials $ ¢

(a) Plumbing

(b) Drainage (including stormwater)

..... Regd. No. ..... Licensed Plumber


..... Regd. No. ..... Licensed Drainlayer

Dated this ..... day of ..... 19.....

Building Permit 38640 Drainage Permit A19523 Plumbing Permit 028513

Plumbing & Drainage Costs ..... Plumbing & Drainage Fees .....

Details of drainage and boundaries required overleaf.

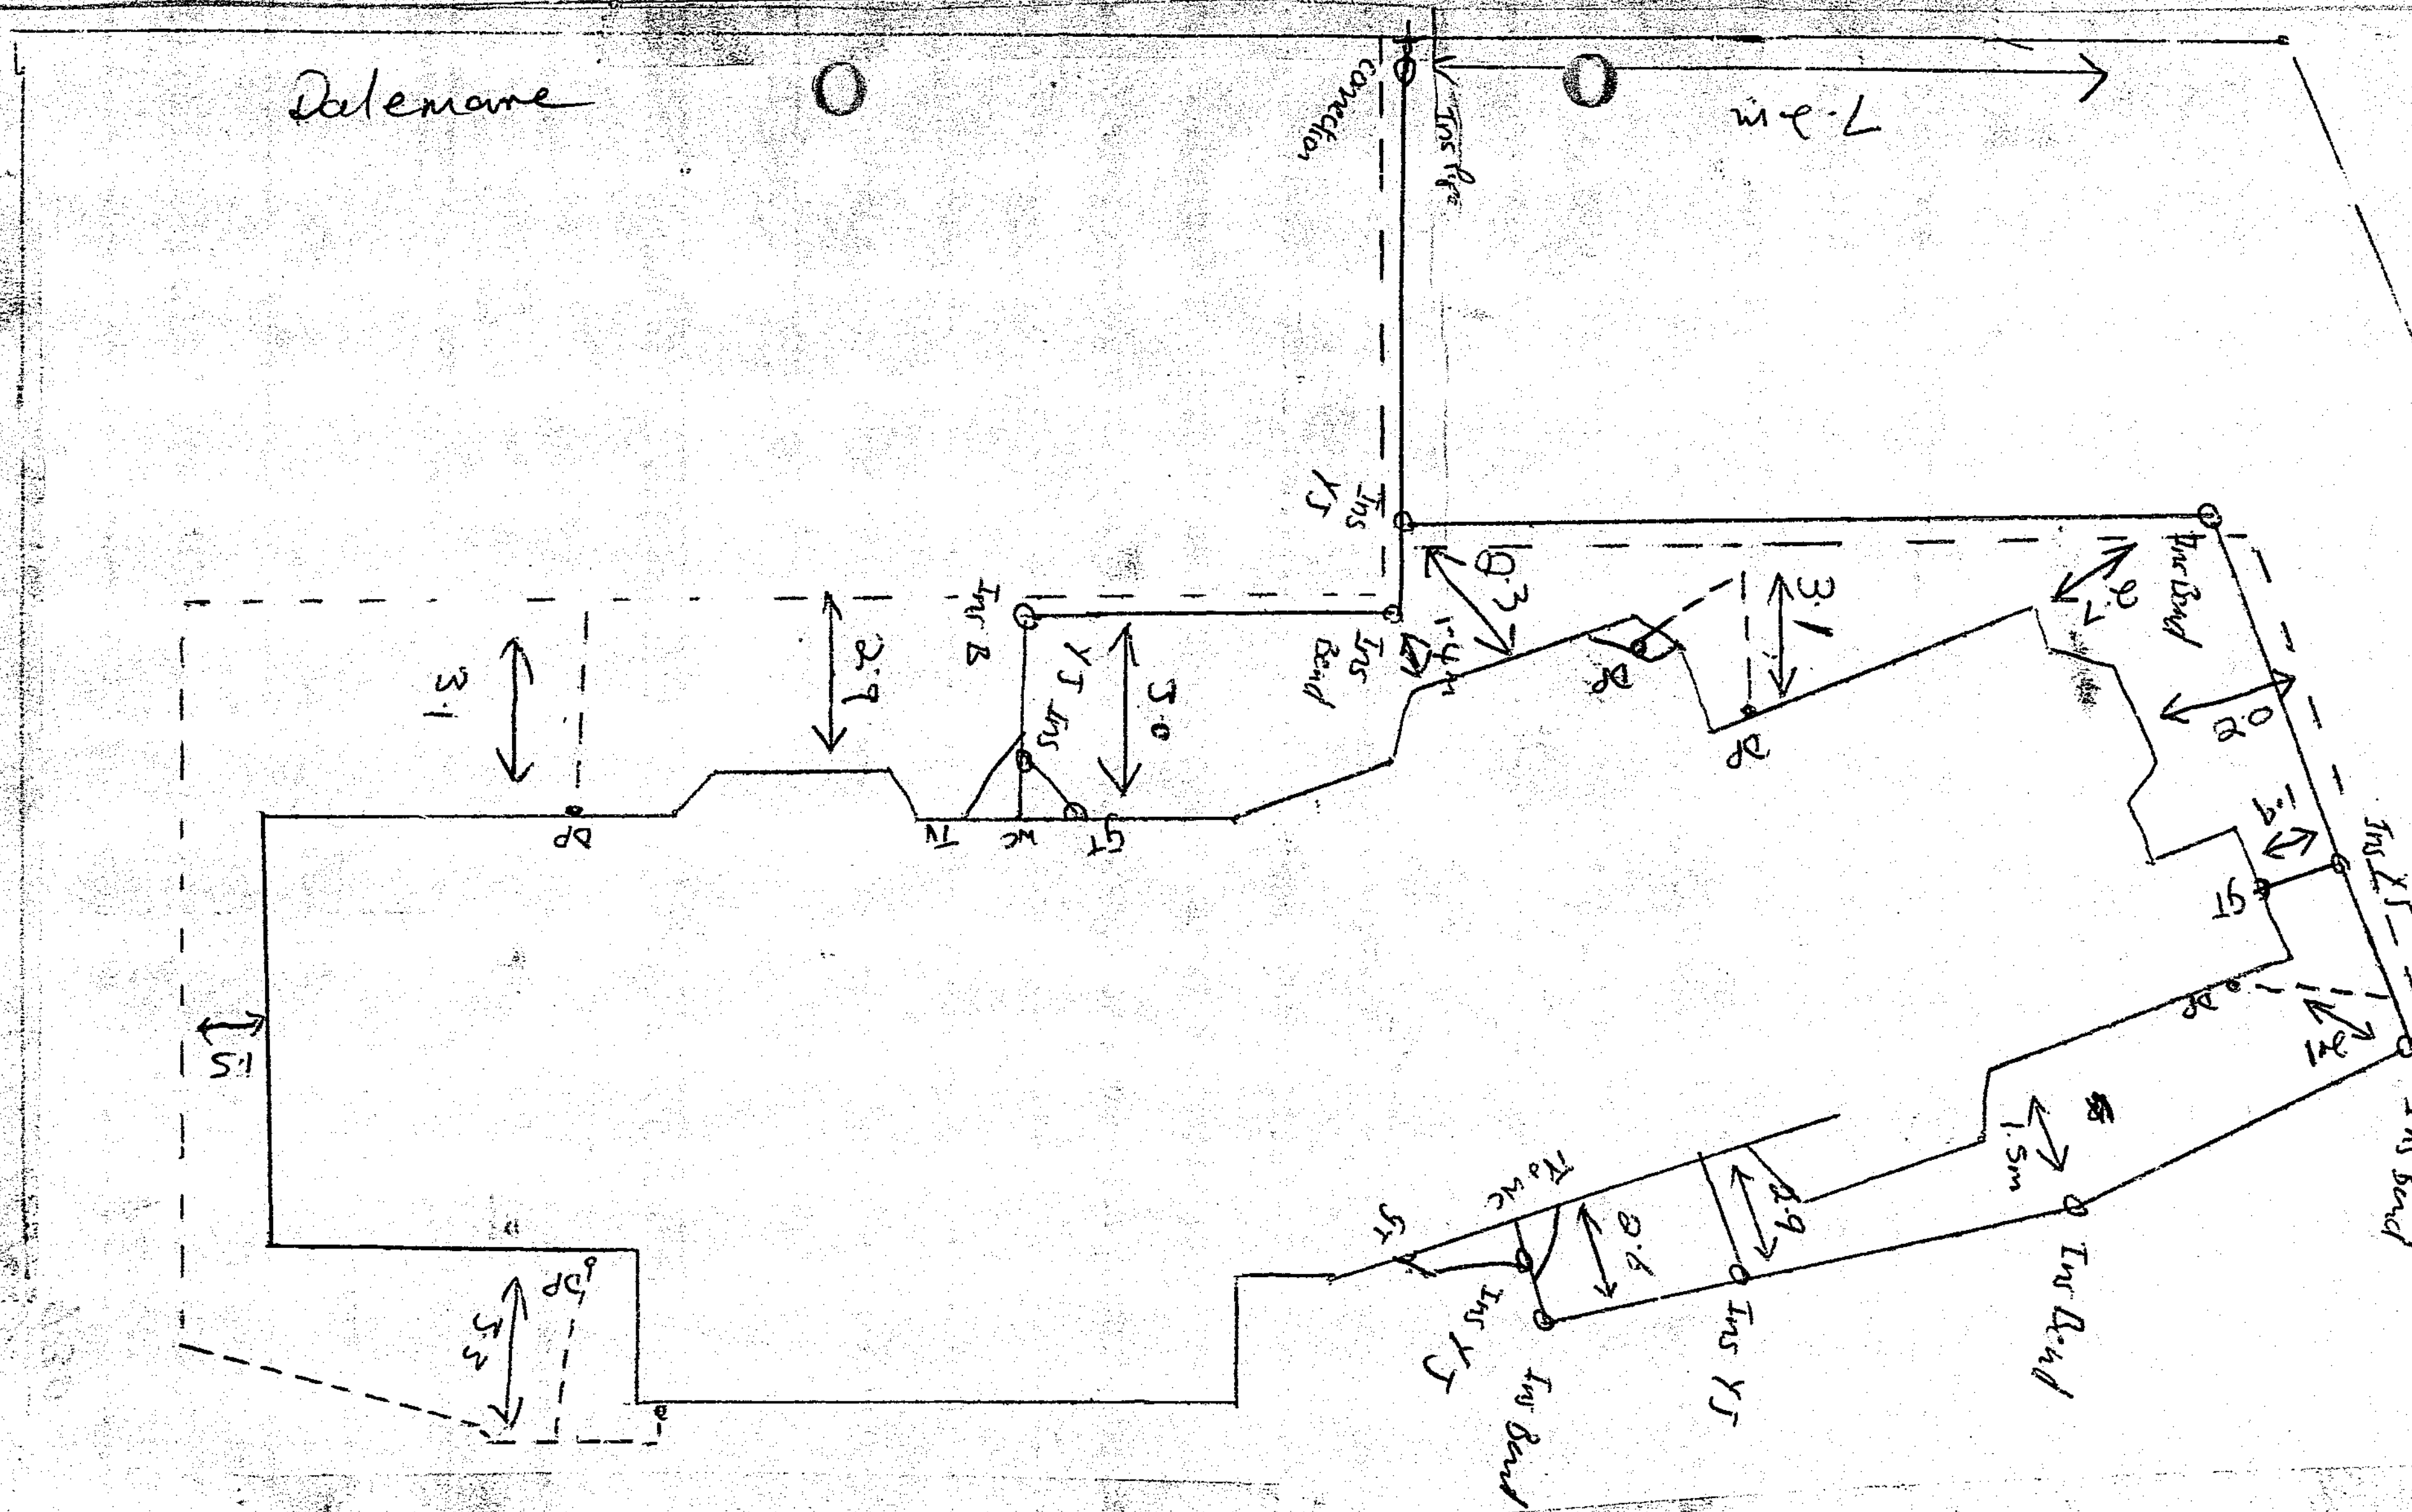

Date of Inspection ....

Drainlayer's Signature ....