As Laid

OFFICE OF THE CHIEF BUILDING INSPECTOR,
BARTON STREET,
PRIVATE BAG, HAMILTON, N.Z
PHONE 81-919

HAMILTON CITY

APPLICATION FOR PERMIT FOR SANITARY, PLUMBING AND DRAINAGE WORK

I, the undersigned (name in full) Hamilton Plumbing Co address Kahikatea Drive

Hereby make application for permission to carry out the work prescribed herein, as set out in the plans attached hereto, at the premises situated in:-

2 Fowlers Ave Street/Road, being Lot ..... D.P.S. .....

Name and Address of owner of premises: R. Hannah .....

Nature of Work Extension to S/W & Sewer drains .....

Value of proposed work excluding materials $ c

(a) Plumbing

(b) Drainage (including stormwater)

..... Regd. No. ..... Licensed Piumber

..... Regd. No. S. Gunn Licensed Drainlayer

Dated this 31st day of Oct 19 86


Building Permit GR 792160 Drainage Permit 27112 Plumbing Permit 27112

Plumbing & Drainage Costs ..... Plumbing & Drainage Fees .....

Details of drainage and boundaries required overleaf.

STREET .....

0 5 10 15 20 25

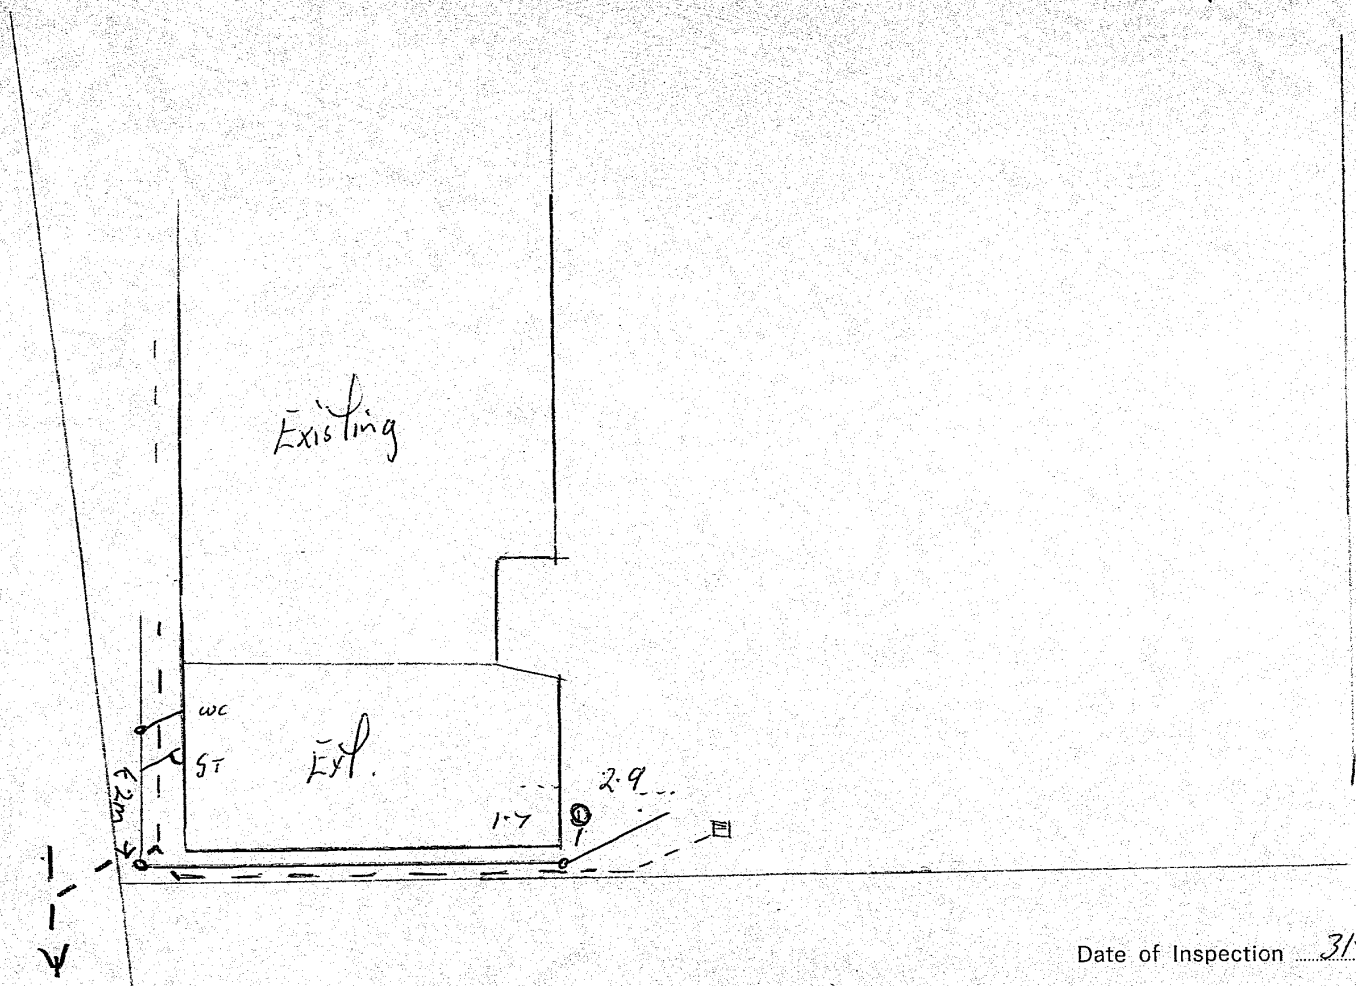

2 Fowlers Ave.

Date of Inspection 31-10-86 GCOL

Drainlayer's Signature .....